



**Plan Drawing Key**

- Existing Masonry Wall
- Existing Concrete Wall
- Existing Framed Wall

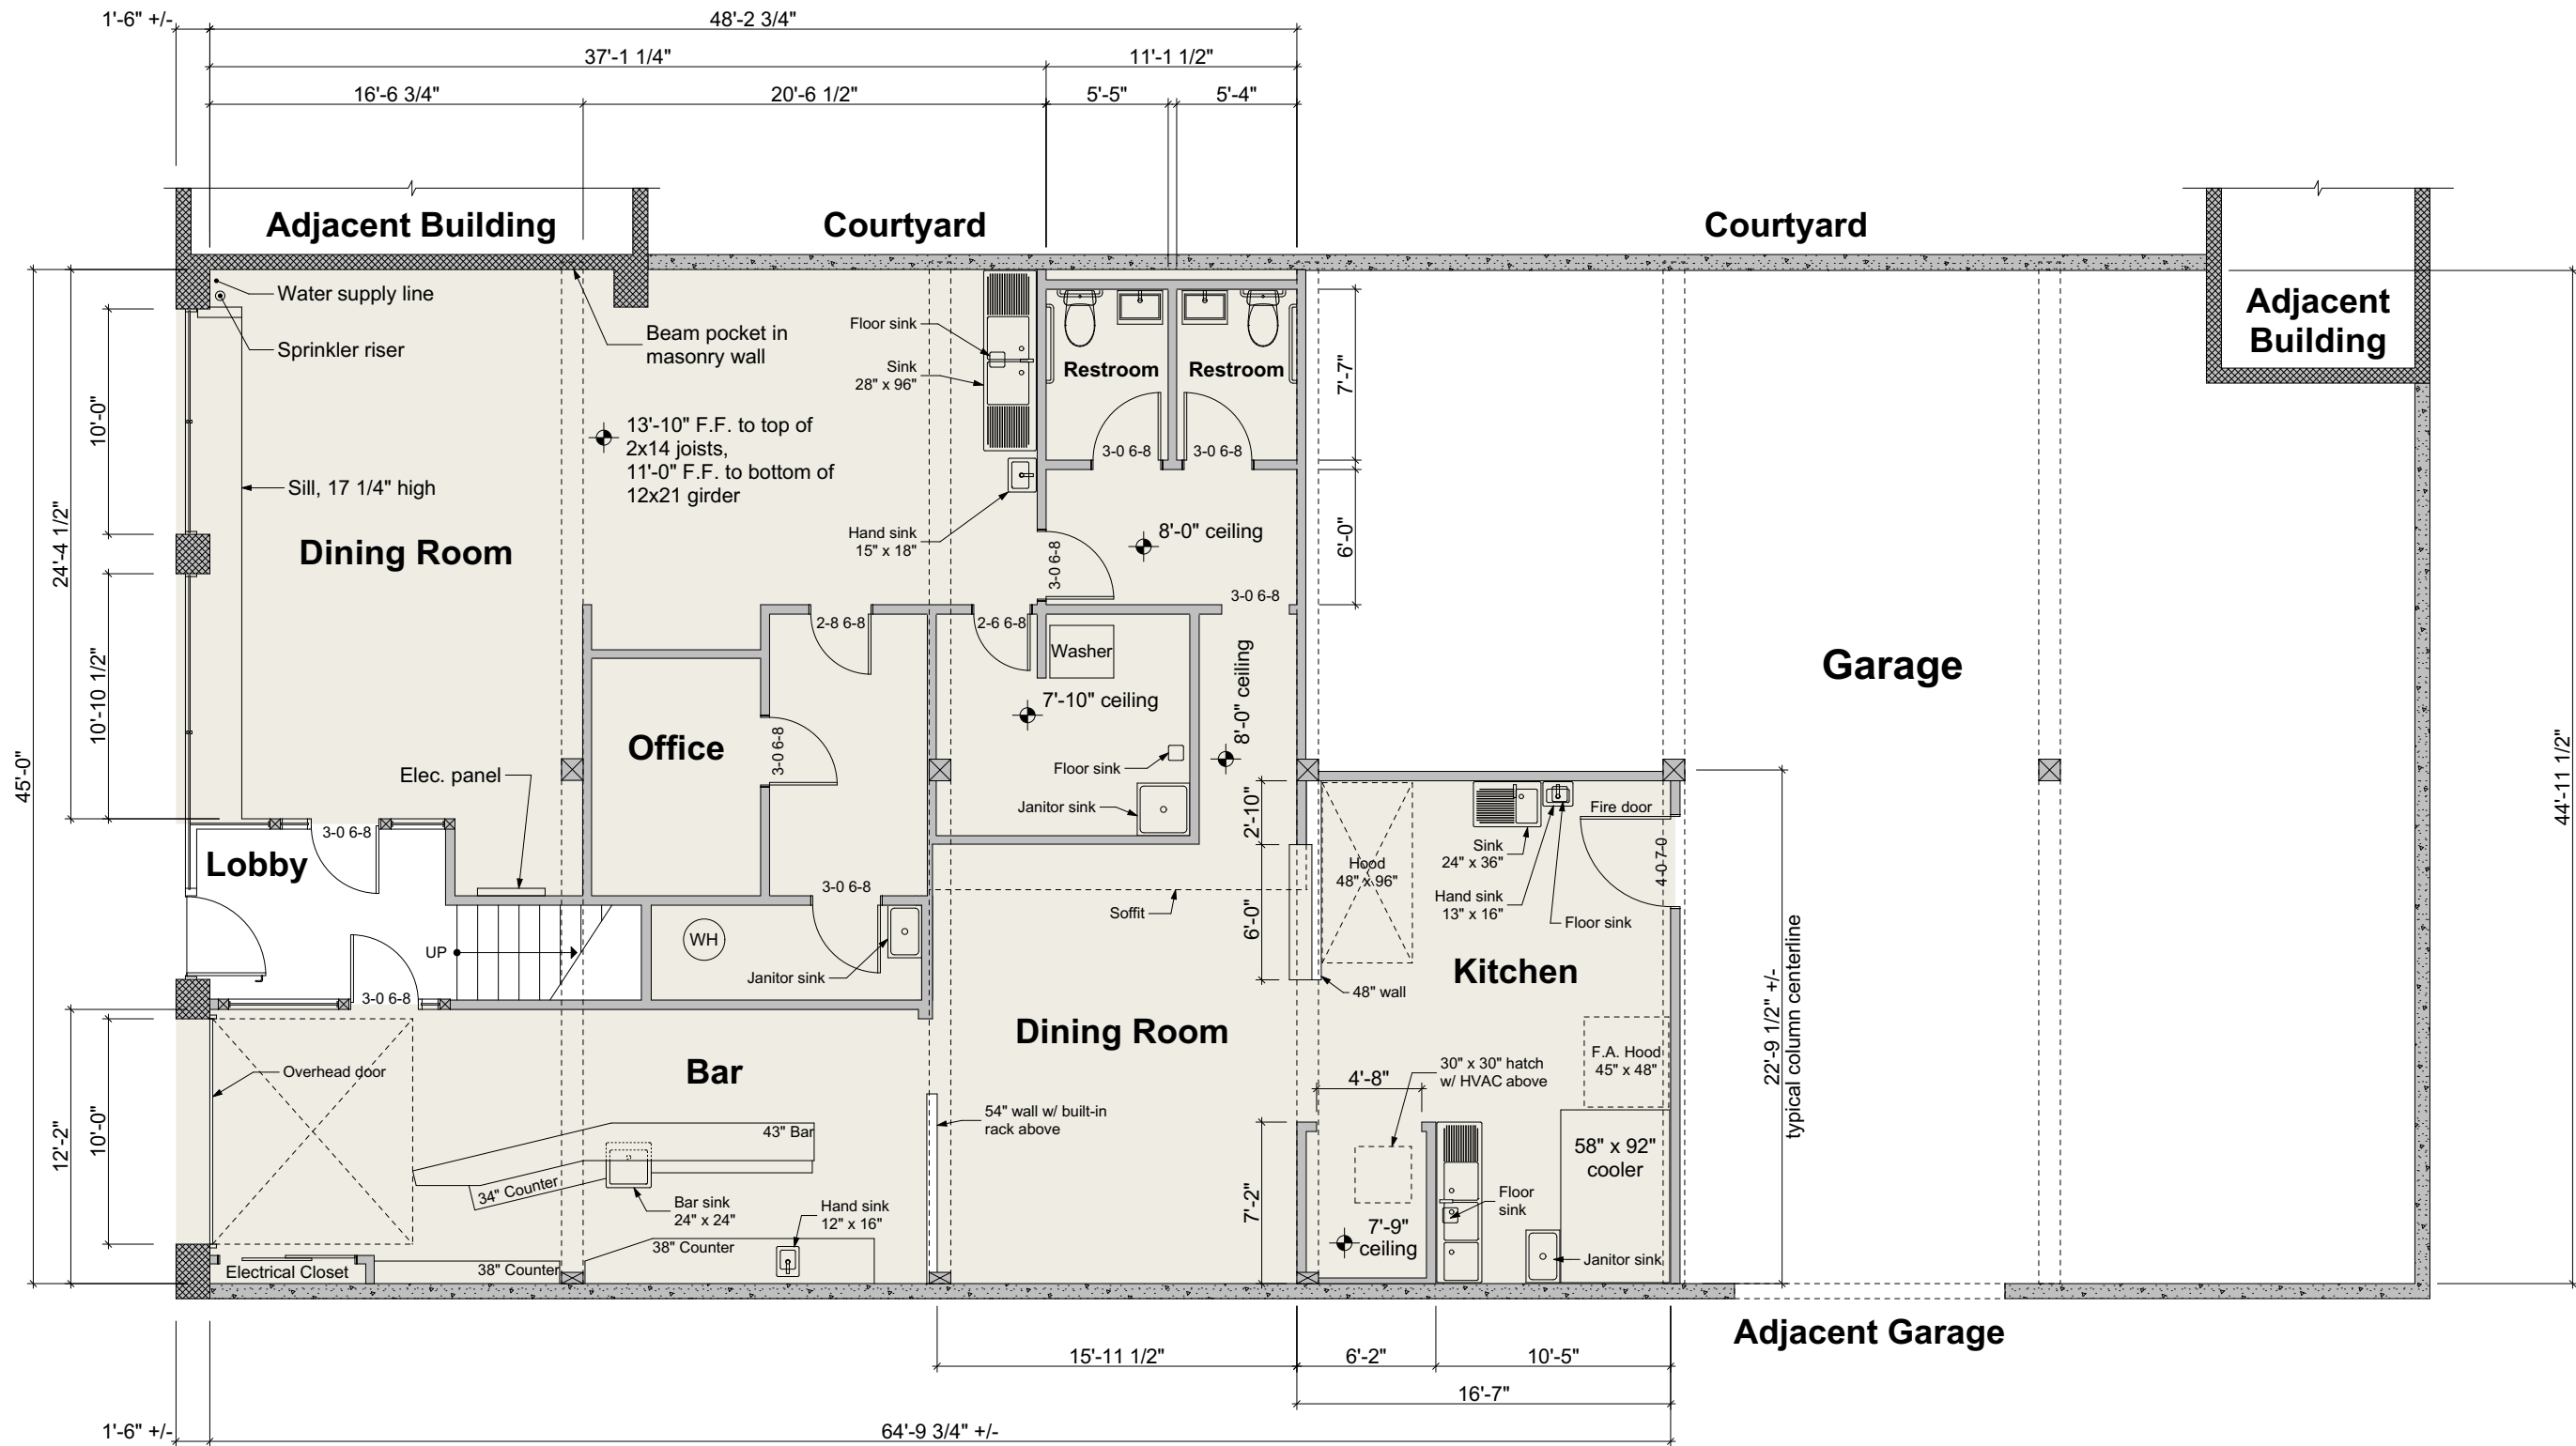

**1 First Floor Plan**

AB.1 1/8" = 1'-0"

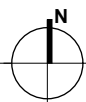

Tad M Raines Drafting and Design  
(540) 746-3159  
tadraines@gmail.com



LL Nutt  
design services  
503-282-9740  
vnutt@spiritone.com

**422 NW 8th Avenue**  
422 NW 8th Avenue  
Portland, OR 97209

**As-built**


Project Number  
**2018-008**

Date  
**10/16/2018**

**AB.1**


**Plan Drawing Key**

- Existing Masonry Wall
- Existing Concrete Wall
- Existing Framed Wall

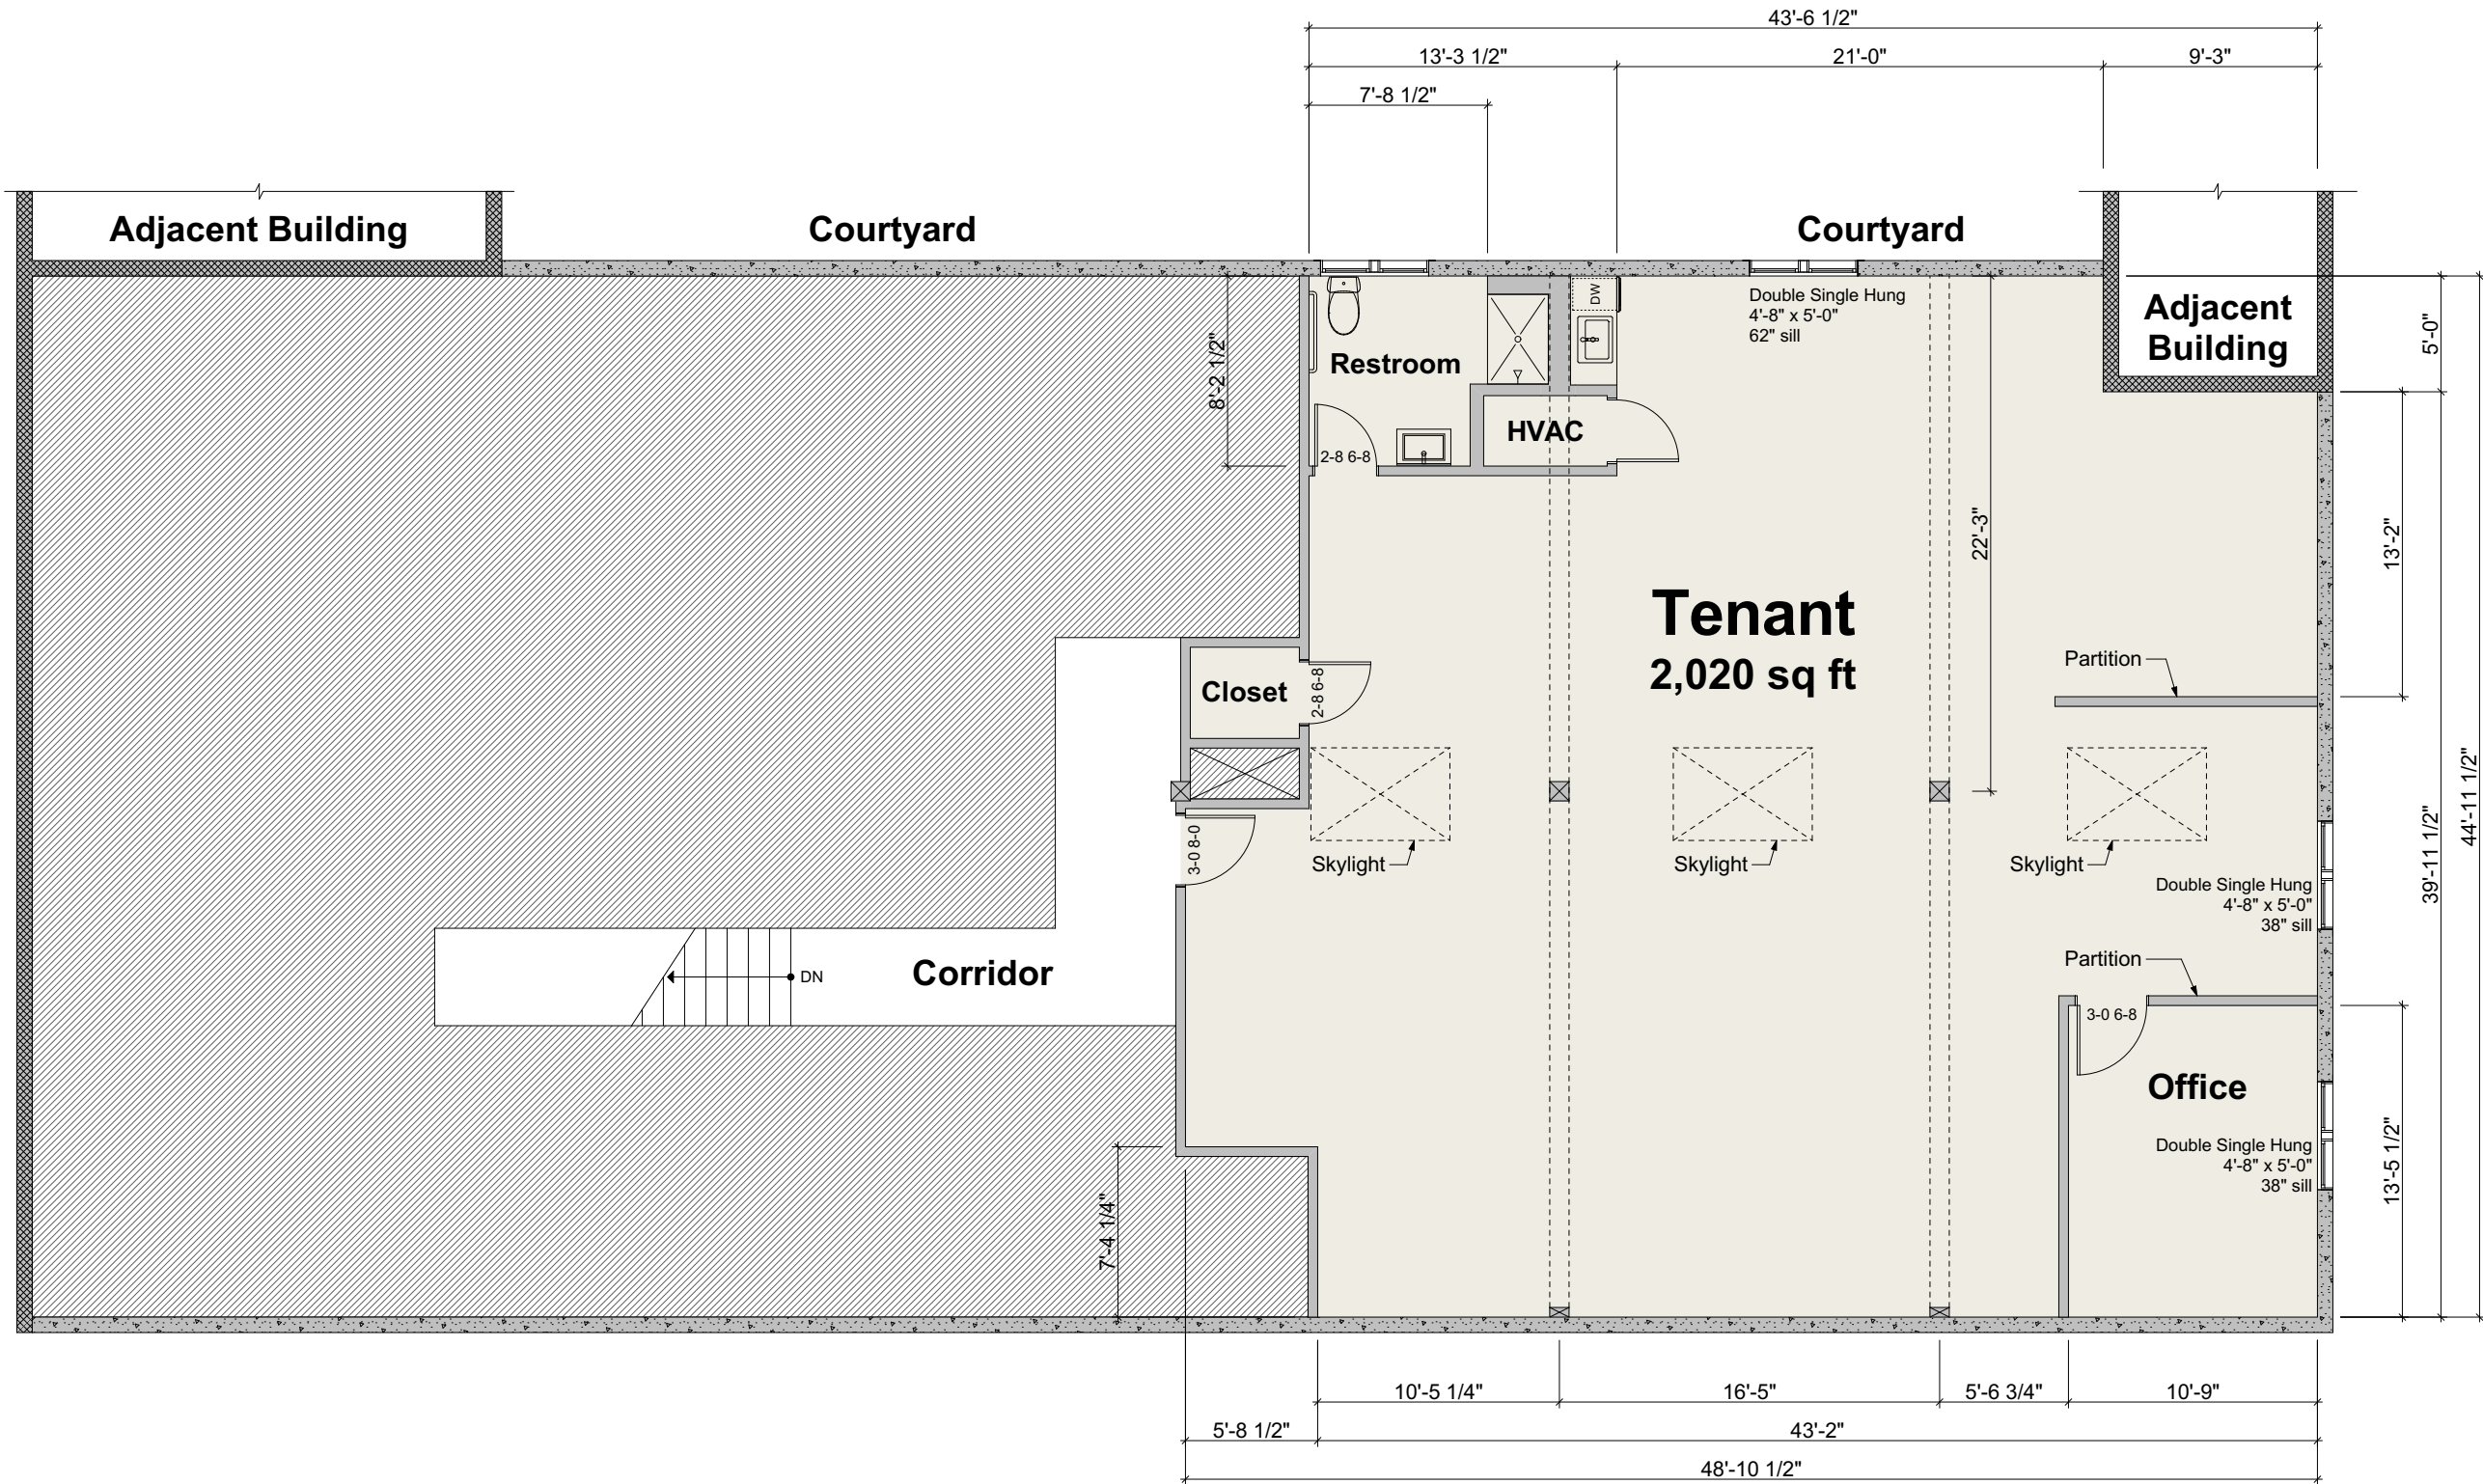

**1 Second Floor Plan**

AB.2 1/8" = 1'-0"

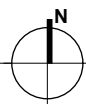

Tad M Raines Drafting and Design  
(540) 746-3159  
tadraines@gmail.com

LL Nutt  
design services  
503-282-9740  
vnutt@spiritone.com



**422 NW 8th Avenue**  
422 NW 8th Avenue  
Portland, OR 97209

**As-built**

Project Number  
**2018-008**

Date  
**10/16/2018**

**AB.2**